
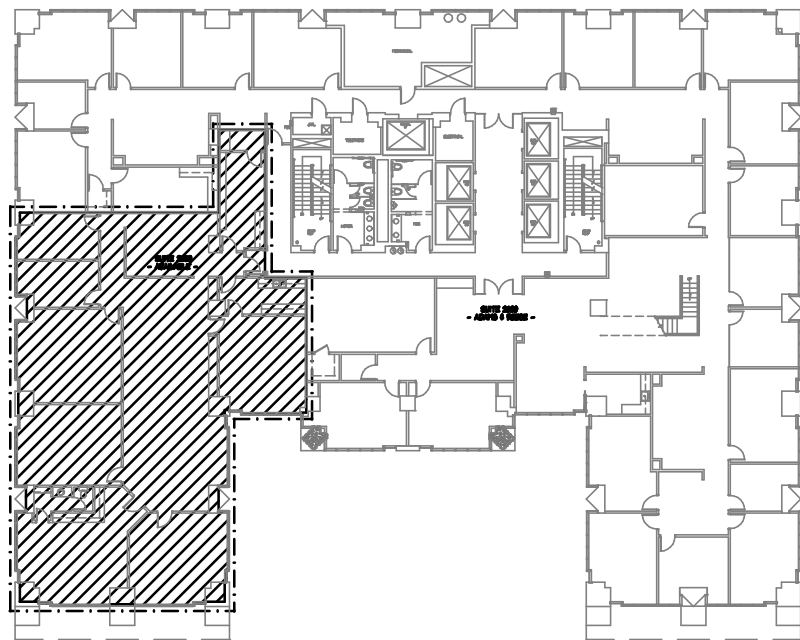


Corporate

Interior

Design

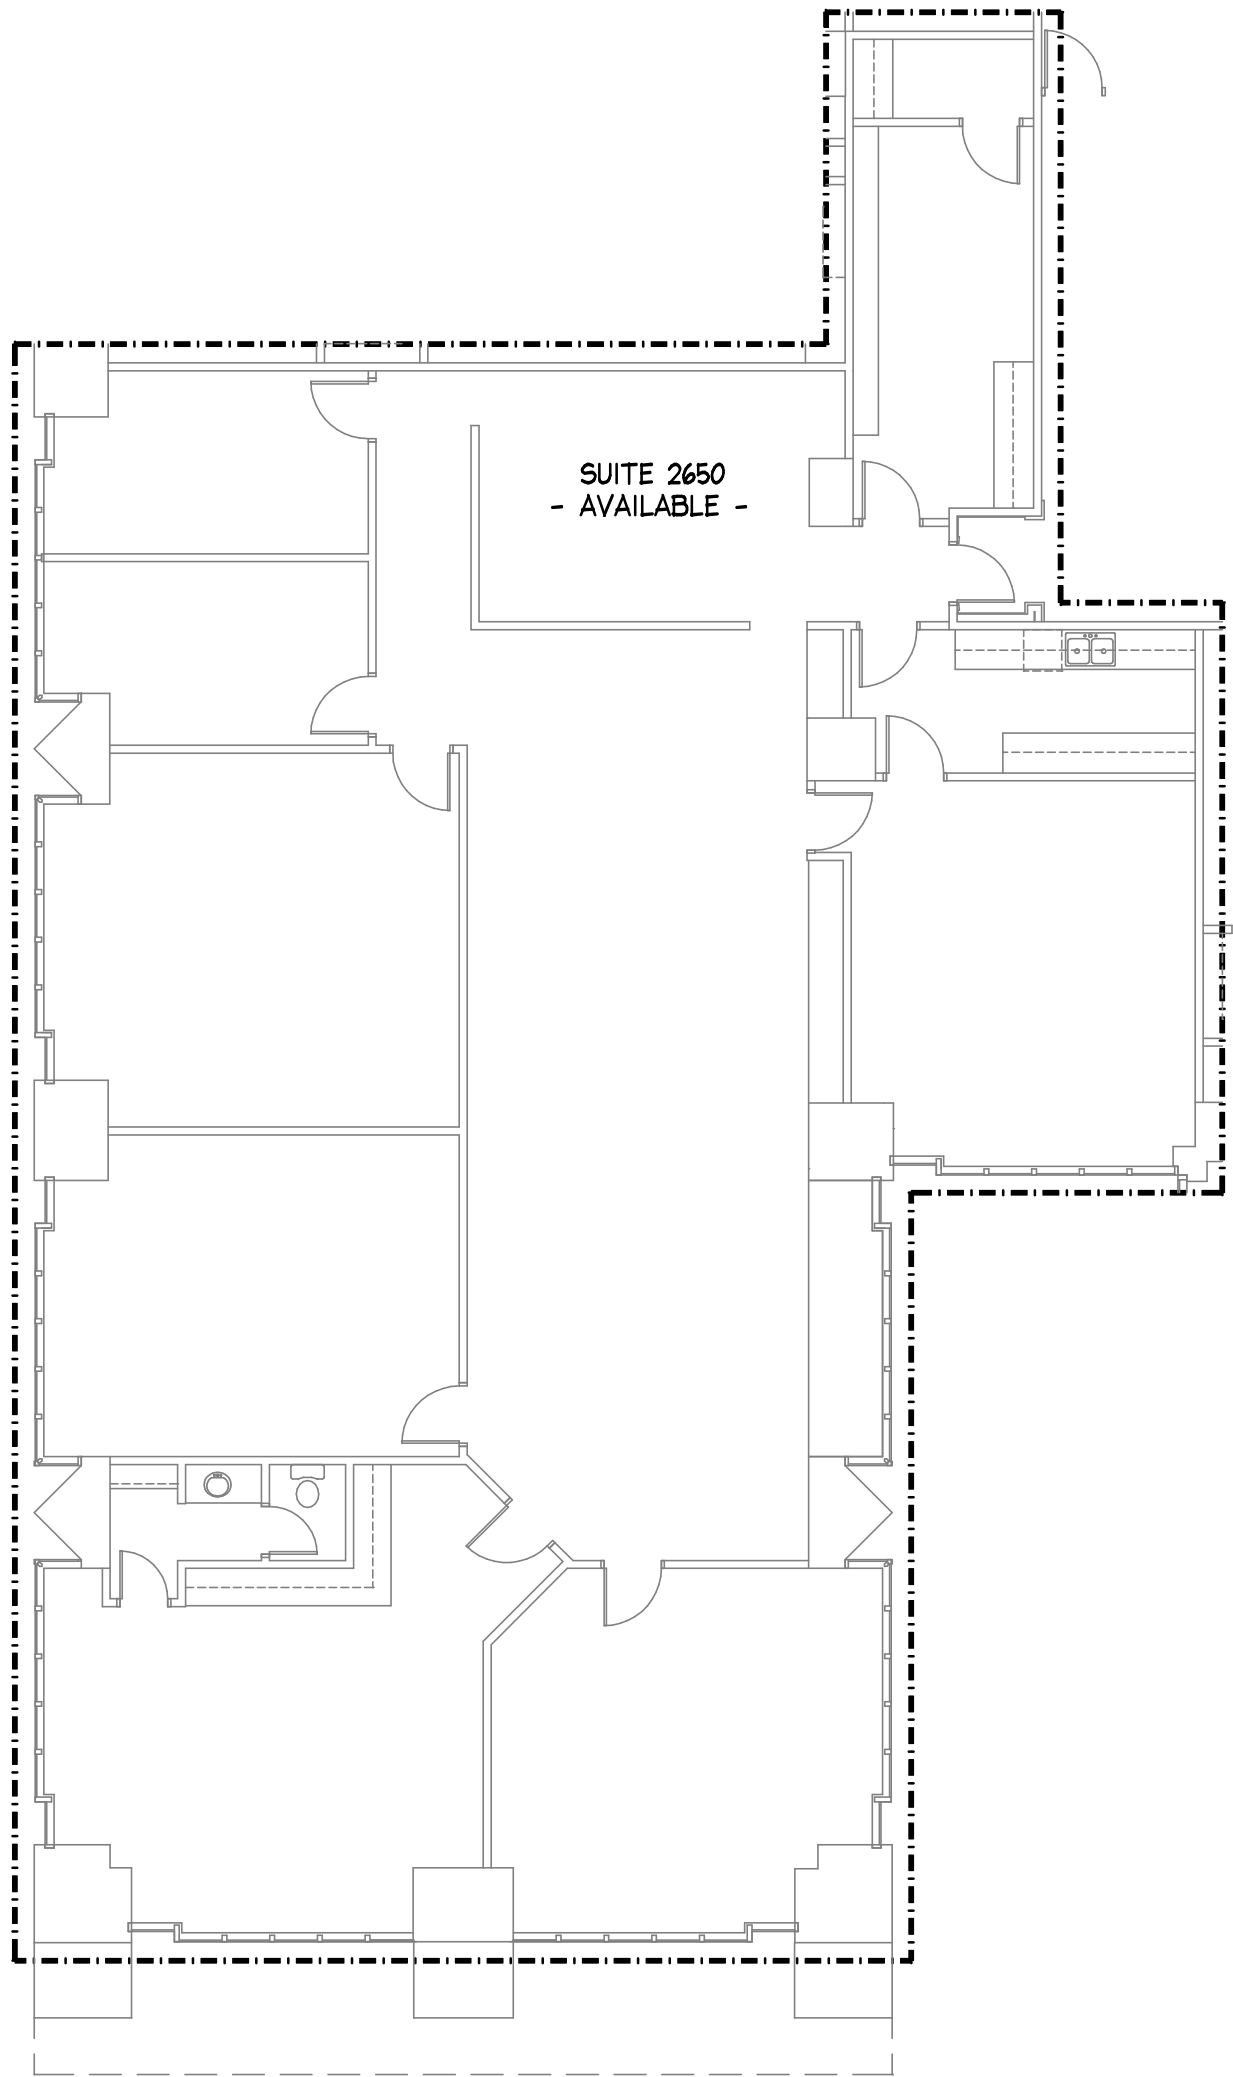

KEY PLAN

2115 Eighth Avenue South
Nashville, Tennessee
37204
PH: (615) 728-1141
FAX: (615) 728-1088

PROJECT: FIFTH THIRD CENTER 424 CHURCH STREET SUITE 2650 NASHVILLE, TN 37219		DATE: 11/17/2014
RE: AS-BUILT SCALE: NOT TO SCALE	SHEET: 1 OF 1	JOB #: 8710-000